
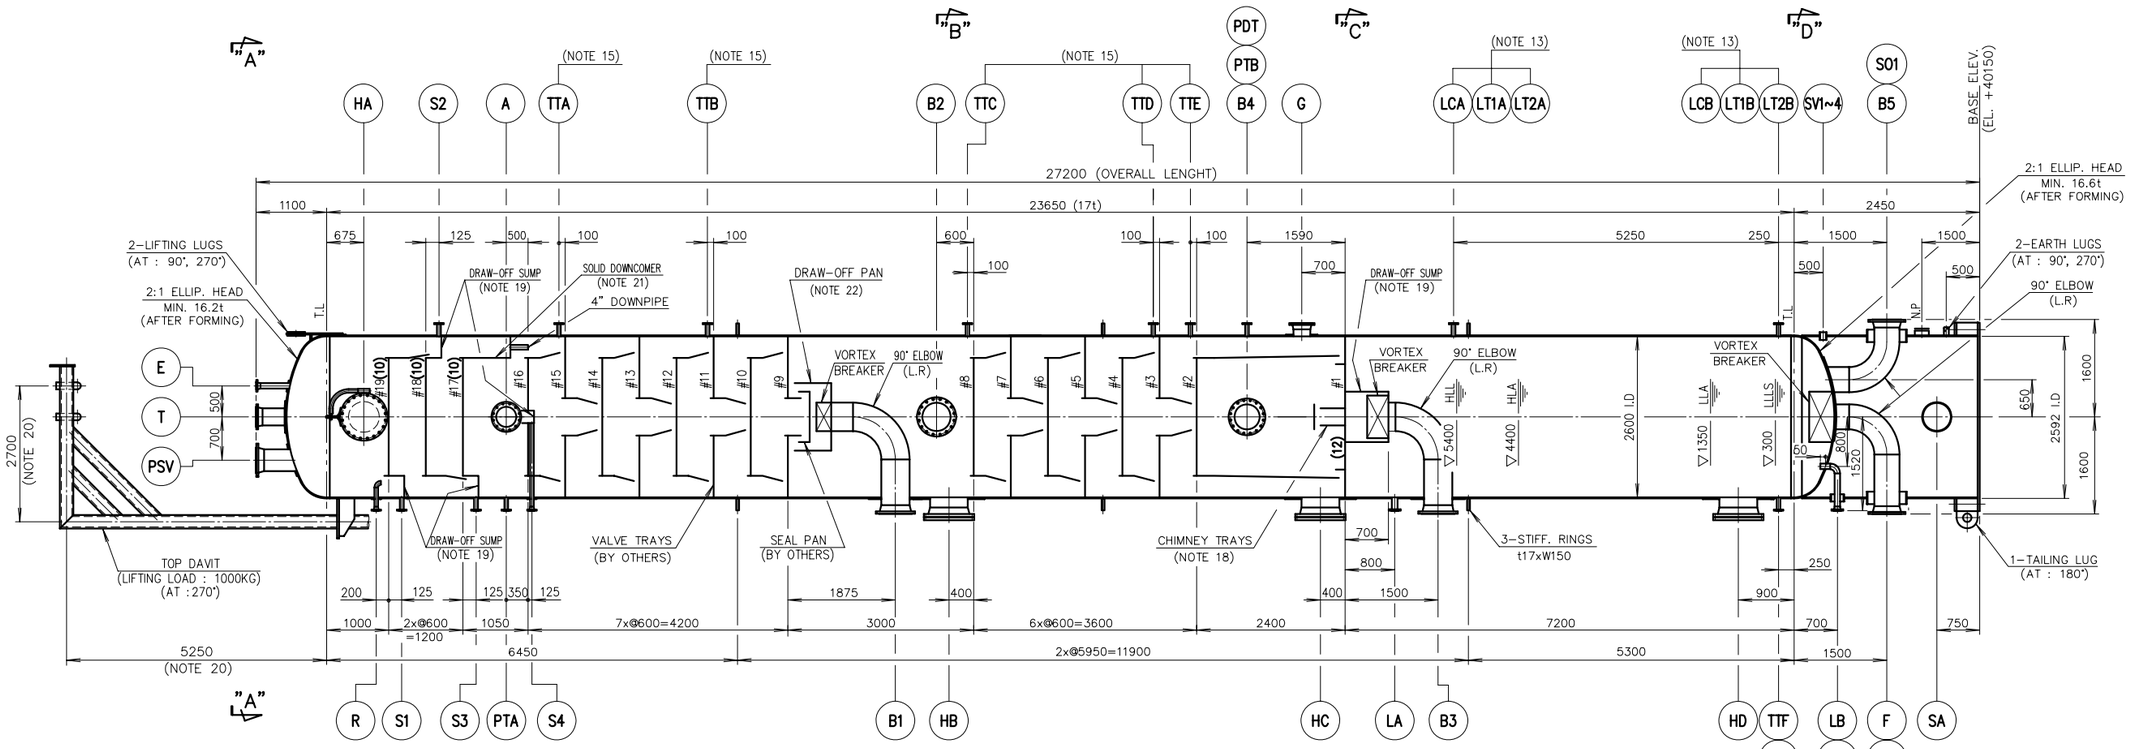


MARK NO.	NO. REQ'D	SIZE (INCH)	ASME RATING	TYPE & FACING	DESIGNATION	FROM ℄	REMARKS
SA	1	I.D 450	–	–	ACCESS OPENING	–	–
SO3	1	I.D 230	–	–	SLEEVE OPENING	–	–
SO2	1	I.D 620	–	–	SLEEVE OPENING	–	–
SO1	1	I.D 620	–	–	SLEEVE OPENING	–	–
SV1~4	4	4	–	–	SKIRT VENT	–	–
UC	1	2	150#	LWN,RF	UTILITY CONNECTION	1520	
TTA-F	6	2	300#	LWN,RF	TEMPERATURE TRANSMITTER	1520	
T	1	10	150#	WN,RF	OUTLET VAPOR	SEE DWG.	
S4	1	2	150#	WN,RF	WATER DRAW-OFF	1520	
S3	1	2	150#	WN,RF	WATER DRAW-OFF	1520	
S2	1	2	150#	WN,RF	WATER DRAW-OFF	1520	
S1	1	2	150#	WN,RF	WATER DRAW-OFF	1520	
R	1	2	150#	WN,RF	REFLUX	1520	
PSV	1	12	150#	WN,RF	PRESSURE SAFETY VALVE	SEE DWG.	
PTA/B	2	2	150#	LWN,RF	PRESURE TRANSMITTER	1520	
PDT	1	2	150#	LWN,RF	PRESSURE DIFFERENTIALTRANSMITTER	1520	
LT2A/B	2	2	150#	LWN,RF	LEVEL TRANSMITTER (HH)	1520	
LT1A/B	2	2	150#	LWN,RF	LEVEL TRANSMITTER (LL)	1520	
LCA/B	2	2	150#	LWN,RF	LEVEL CONTROL	1520	
LA	1	3	150#	WN,RF	STAND PIPE	1520	
LB	1	3	150#	WN,RF	STAND PIPE	SEE DWG.	
HA-D	4	24	150#	WN,RF	MANHOLES	1600	W/BLIND & DAVIT
G	1	10	150#	WN,RF	RETUM FROM PSV	1550	
F	1	16	150#	WN,RF	OUTLET CONDENSATE	SEE DWG.	
E	1	3	150#	WN,RF	VENT	SEE DWG.	
B5	1	16	150#	WN,RF	LIQUID FROM REBOILER	SEE DWG.	
B4	1	16	150#	WN,RF	VAPOR FROM REBOILER	1570	
B3	1	18	150#	WN,RF	TO REBOILER	1570	
B2	1	18	150#	WN,RF	FROM SIDE REBOILER	1570	
B1	1	18	150#	WN,RF	TO SIDE REBOILER	1570	
A	1	12	150#	WN,RF	INLET FEED	1550	

NOZZLE SCHEDULE

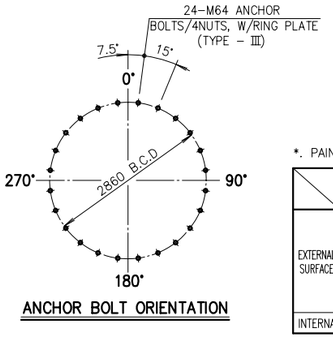

ANCHOR BOLT ORIENTATION

*. PAINTING SPECIFICATION. (DOC. NO. RP-6340S-999-6600-0001)

	PART NAME	SURFACE PREPARATION	PAINT SPECIFICATION			
			SYSTEM NO.	PRIMER	INTERMEDIATE	FINAL COAT
EXTERNAL SURFACE	SHELL & HEAD	Sa 2 1/2	3	1 x 125 MICRONS THERMALINE 400 OR EQ.	-	1 x 125 MICRONS THERMALINE 400 OR EQ.
	SUPPORT (INSIDE & OUTSIDE)	Sa 2 1/2	3	1 x 125 MICRONS THERMALINE 400 OR EQ.	-	1 x 125 MICRONS THERMALINE 400 OR EQ.
INTERNAL SURFACE		N/A	N/A	N/A	N/A	N/A

MATERIAL SPECIFICATIONS

SHELL, HEADS / REINFORCING PADS	A516-60N
SKIRT / SKIRT BASE RING	A516-60N/A285-C
FORGED NOZZLES & COVERS	A105N
STANDARD FLANGES & COVERS	A105N
PIPE NOZZLE NECKS / FITTINGS	A106-B/A234-WPB
INTERNAL WELDED TO SHELL	A516-60N
EXTERNAL WELDED TO SHELL	A516-60N
EXTERNAL LUGS / LIFTING LUGS	A516-60N
INTERNALS	SS 304L
INTERNAL PIPE / FITTINGS (REMOVAL)	A312-TP304L/A403-WP304L
EXTERNAL BOLTS/NUTS	A193-B7/A194-2H
INTERNAL BOLTS/NUTS	A193-B8/A194-8
EXTERNAL GASKETS	SEE NOTE 14
INTERNAL GASKETS	-
PAINTING	SEE NOTE 8
INSULATION	MINERAL WOOL
NAME PLATE, EARTH LUG	304 S.S
ANCHOR / ~~SETTING~~ BOLT/NUT	A307-B/A563-A
TRAYS (#1~#15 / #16~#19)	S.S 304L/S.S 321

DESIGN DATA


CODE	ASME SEC.VIII DIV.1 '01 ED. '02 ADD.	CORR. ALLOW.	3 mm
CODE STAMP	NO	SPEC. GR. (MIN./NOR./MAX.)	0.582/0.586/0.75
FLUID NAME	STABILIZED CONDENSATE	OPER. PRESS.(TOP/BTM.)	9.4/9.7 barg
DESIGN PRESS.(TOP/BTM.)	11.5~11.8 **(11)** barg	OPER. TEMP.(TOP/BTM.)	68.8~70.5/178.5~190 °C
EXTERNAL PRESS.	F.V @ 5°C barg	M.D.M.T	-29°C @ 11.5~11.8 barg
DESIGN TEMP.(TOP/BTM.)	110~225 **(11)** °C	RADIOGRAPH TEST (S/H)	FULL/FULL
HYDRO. TEST PRESS.	AS PER CODE barg	INSULATION (HOT)	60 mm
P.W.H.T	YES	FIRE PROOFING	50 (SKIRT IN & OUTSIDE) mm
JOINT EFFICIENCY(S/H)	100/100 %	EARTHQUAKE	ZONE 4
WIND VELOCITY	34.7 m/sec	LETHAL SERVICE	YES
TYPE OF HEADS	2 :1 ELLIP.	SOUR SERVICE	YES **(7)**

WEIGHT & CAPACITY (ESTIMATED)

ERECTION	46719 Kg	CAPACITY	130 M^3
EMPTY	60830 Kg	FULL OF WATER	191313 Kg
PLATFORM & LADDER	5555 Kg	OPERATING	88100 Kg
INSULATION	2975 Kg		
INTERNAL(TRAYS)	6362 Kg		
FIRE PROOF.	5581 Kg		

GENERAL NOTES

1. ALL DIMENSIONS ARE IN MM UNLESS OTHERWISE NOTED.
2. ALL THICKNESS SHOWN ON THIS DRAWING SHALL BE CONSIDERED AS A MINIMUM REQUIRED THICKNESS. VENDOR SHALL CONFIRM ACTUAL THICKNESS UNDER HIS MECHANICAL GUARANTEE ACCORDINGLY.
3. ALL WELDS TO BE CONTINUOUS EXCEPT AS NOTED.
4. ALL WELD INSIDE SURFACE OF NOZZLES TO BE FULLY FLUSHED.
5. ALL BOLT HOLES ARE TO STRADDLE THE NORTH/SOUTH AND VERTICAL CENTER LINES.
6. THE REMOVABLE INTERNALS SHALL BE DESIGNED SO AS TO BE ASSEMBLED/DISASSEMBLED THROUGH MANHOLE.
7. WET SOUR SERVICE SHALL BE APPLIED ACCORDING TO THE DOC. NO. RP-6340S-999-6300-0002.
8. PAINTING AND SURFACE PREPARATION SHALL BE AS PER SHOP AND FIELD PAINTING SPECIFICATION. (DOC. NO. RP-6340S-999-6600-0001)
9. WITHOUT LIQUID HEAD (IN VAPOR PHASE)
10. TRAYS 17 TO 19 ROTATE 90° RELATIVE TO TRAY 16
11. STEAM OUT CONDITION TO BE CONSIDERED : ATM. @ 150°C OR F.V @ 5°C
12. TIGHT SEAL CHIMNEY TRAY. LIQUID FROM TRAY #1 IS DRAWN-OFF TO REBOILER.
13. LEVEL INSTRUMENT BOTTOM NOZZLE TO BE INSTALLED IN ORDER TO AVOID SLUDGE ACCUMULATION.
14. GASKET MATERIAL FOR ASME B16.20 : SPIRAL WOUND (4.5t)
    FILLER : GRAPHITE 98%
    HOOP : 316 S.S
    INNER RING : 316 S.S
    OUTER RING : 316 S.S
15. TTA ~ TTE TO BE LOCATED IN THE DOWNCOMER AT 100 mm ABOVE THE TRAY BELOW (IN THE LIQUID PHASE)
16. SPECIFIED DIMENSIONS FOR ALL TRAY ELEVATION SHALL BE TOP OF TRAY SUPPORT RING.
17. INTERNAL LADDER SHALL BE PROVIDED ACCORDING TO STANDARD NO. 6340S-L-C027.
18. CHIMNEY TRAY SHALL BE SUPPLIED BY TRAY VENDOR. HOWEVER, IT SHALL BE WELDED AT BY VESSEL VENDOR'S AT HIS SHOP.
19. DRAW-OFF SUMP SHALL BE FABRICATED AND INSTALLED BY VESSEL VENDOR.
20. TO BE CONFIRMED BY VESSEL VENDOR DURING DETAIL DESIGN STAGE.
21. SOLID DOWNCOMER & 4" DOWNPIPE SHALL BE FABRICATED AND INSTALLED BY VESSEL VENDOR.
22. DRAW-OFF PAN SHALL BE FABRICATED AND INSTALLED BY VESSEL VENDOR.

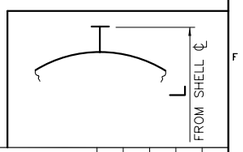

REV.	DATE	DESCRIPTION	ORIG.	PREP.	CHKD.	APPD.	CONT. APPD.
4	28/FEB/'09	AS BUILT	GS	N.H.L.	B.K.K.	S.R.K.	S.S.P.
3	16/FEB/'06	FOR FINAL	GS	N.H.L.	B.K.K.	S.R.K.	S.S.P.
2	05/AUG/'05	APPROVED FOR CONSTRUCTION	GS	N.H.L.	D.H.L.	S.R.K.	S.S.P.
1	30/JUL/'04	ISSUED TO COMPANY	LG	N.H.L.	D.H.L.	S.R.K.	S.S.P.
0	19/JAN/'04	ISSUED FOR APPROVAL	LG	S.R.K.	H.C.S.	-	H.S.K.
A	20/NOV/'03	ISSUED FOR REVIEW	LG	S.R.K.	H.C.S.	-	H.S.K.

SOUTH PARS GAS FIELD DEVELOPMENT-PHASES 9 & 10, ASSALUYEH-IRAN ONSHORE FACILITIES

PARS OIL AND GAS COMPANY

PROJECT No.: PGGC-760-81-156 | DOC. CLASS. 2 | SCALE : NONE

OIEC

TITLE:

103-C-101/201
CONDENSATE STABILISER

DWG No. DW-6340S-103-0510-0101 | SHEET No. 1 OF 4 | REV. 4

NOTE: THIS DOCUMENT IS A PROPERTY OF NIOC AND CAN NOT BE COPIED AND HANDED TO THIRD PARTY WITHOUT CLIENT'S AUTHORIZATION
CAD REFERENCE No.