

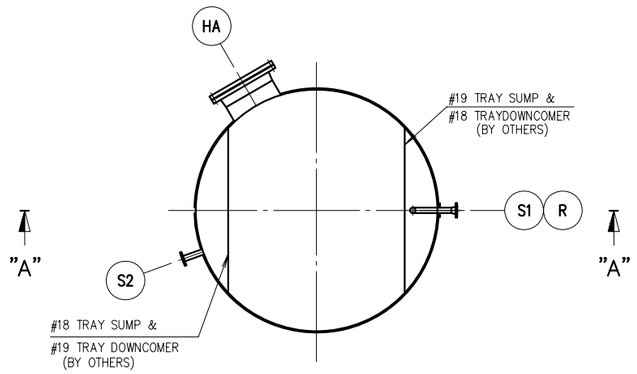



DETAIL OF REFLUX

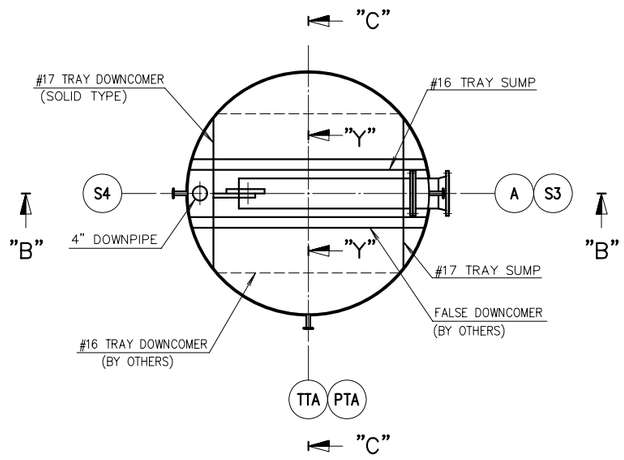

DETAIL OF INLET FEED

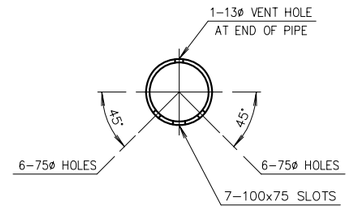


VIEW "Y"-"Y"

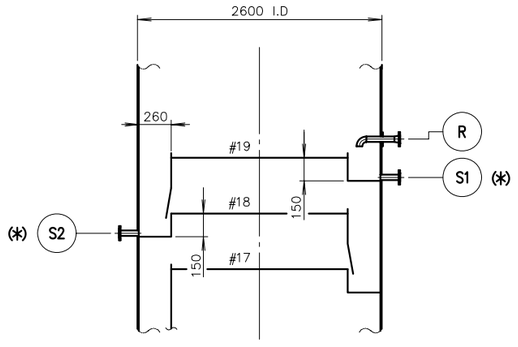


VIEW "A"-"A"

(*) S1, S2 NOZZLE (ID) BOTTOM TO BE FLUSH WITH THE SUMP.

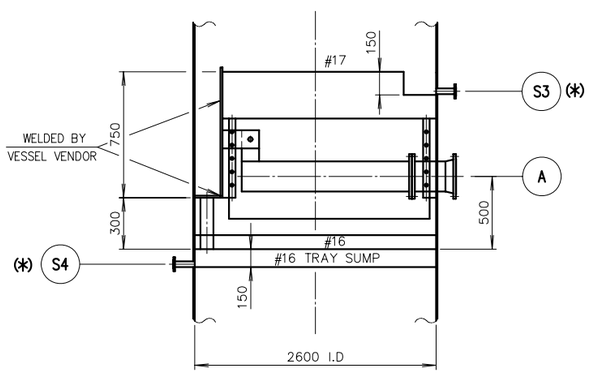


VIEW "B"-"B"

(*) S3, S4 NOZZLE (ID) BOTTOM TO BE FLUSH WITH THE SUMP.

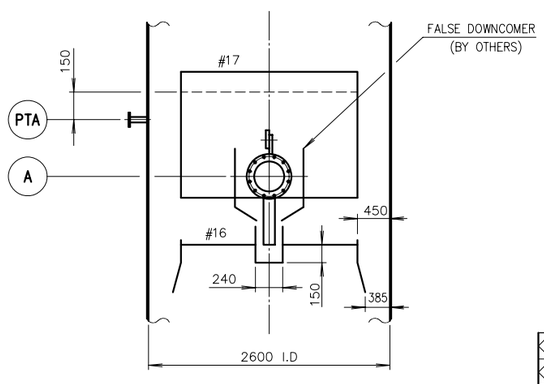

VIEW "C"-"C"

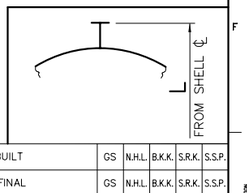

REV.	DATE	DESCRIPTION	ORIG.	PREP.	CHKD.	APPD.	CONT. APPD.
4	28/FEB/'09	AS BUILT	GS	N.H.L.	B.K.K.	S.R.K.	S.S.P.
3	16/FEB/'06	FOR FINAL	GS	N.H.L.	B.K.K.	S.R.K.	S.S.P.
2	05/AUG/'05	APPROVED FOR CONSTRUCTION	GS	N.H.L.	D.H.L.	S.R.K.	S.S.P.
1	30/JUL/'04	ISSUED TO COMPANY	LG	N.H.L.	D.H.L.	S.R.K.	S.S.P.
A	22/APR/'04	ISSUED FOR REVIEW	LG	N.H.L.	D.H.L.	S.R.K.	S.S.P.

SOUTH PARS GAS FIELD DEVELOPMENT-
PHASES 9 & 10, ASSALUYEH-IRAN
ONSHORE FACILITIES

N.I.O.C
PARS OIL AND GAS COMPANY

PROJECT No.: POGC-760-81-156 | DOC. CLASS. 2 | SCALE : NONE

OIEC

TITLE:

103-C-101/201
CONDENSATE STABILISER

DWG No. DW-6340S-103-0510-0101 | SHEET No. 2 OF 4 | REV. 4

NOTE: THIS DOCUMENT IS A PROPERTY OF NIOC AND CAN NOT BE COPIED AND HANDED TO THIRD PARTY WITHOUT CLIENT'S AUTHORIZATION
CAD REFERENCE No.: