

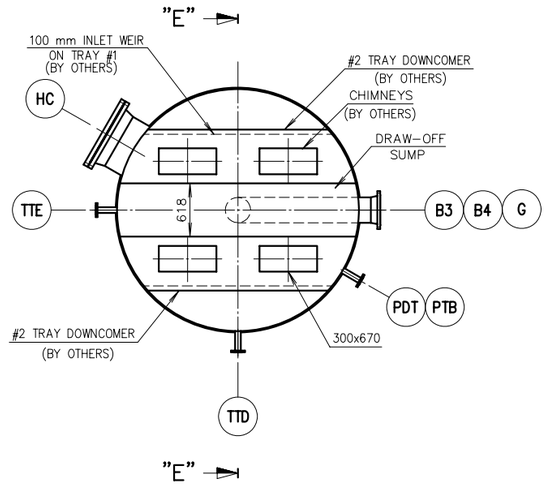



DETAIL OF TO REBOILER

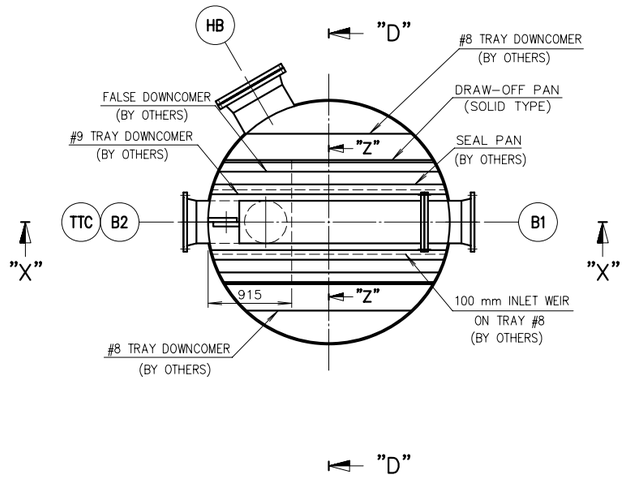


DETAIL OF TO SIDE REBOILER

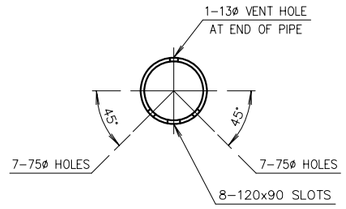


VIEW "Z"-"Z"

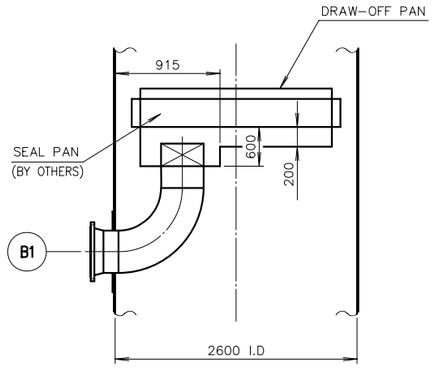


VIEW "X"-"X"

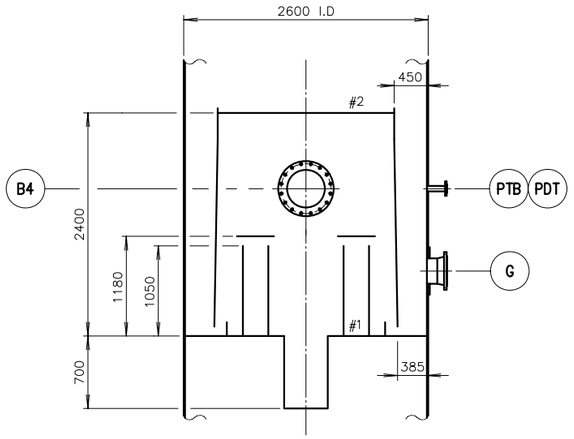

VIEW "E"-"E"

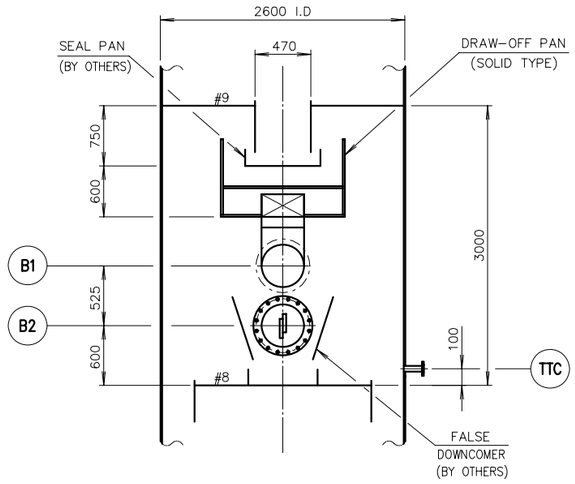

VIEW "D"-"D"

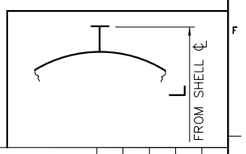

REV.	DATE	DESCRIPTION	ORIG.	PREP.	CHKD.	APPD.	CONT. APPD.
4	28/FEB/'09	AS BUILT	GS	N.H.L.	B.K.K.	S.R.K.	S.S.P.
3	16/FEB/'06	FOR FINAL	GS	N.H.L.	B.K.K.	S.R.K.	S.S.P.
2	05/AUG/'05	APPROVED FOR CONSTRUCTION	GS	N.H.L.	D.H.L.	S.R.K.	S.S.P.
1	30/JUL/'04	ISSUED TO COMPANY	LG	N.H.L.	D.H.L.	S.R.K.	S.S.P.
A	22/APR/'04	ISSUED FOR REVIEW	LG	N.H.L.	D.H.L.	S.R.K.	S.S.P.

SOUTH PARS GAS FIELD DEVELOPMENT-
PHASES 9 & 10, ASSALUYEH-IRAN
ONSHORE FACILITIES

N.I.O.C
PARS OIL AND GAS COMPANY

PROJECT No.: POGC-760-81-156 | DOC. CLASS. 2 | SCALE : NONE

OIEC | IOEC

TITLE:
103-C-101/201
CONDENSATE STABILISER

DWG No. DW-6340S-103-0510-0101 | SHEET No. 3 OF 4 | REV. 4

NOTE: THIS DOCUMENT IS A PROPERTY OF NIOC AND CAN NOT BE COPIED AND HANDED TO THIRD PARTY WITHOUT CLIENT'S AUTHORIZATION
CAD REFERENCE No.