

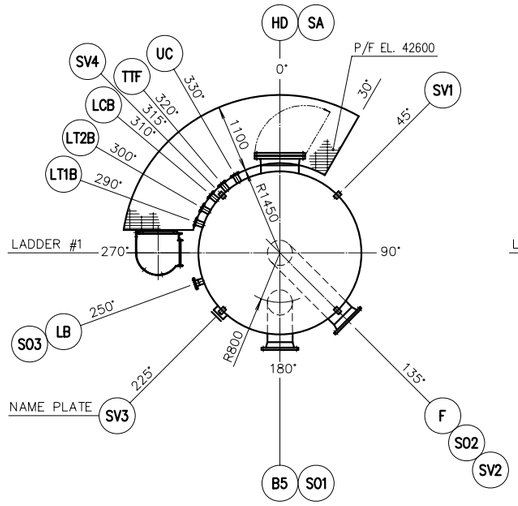



EL. 40000 ~ EL. 47400

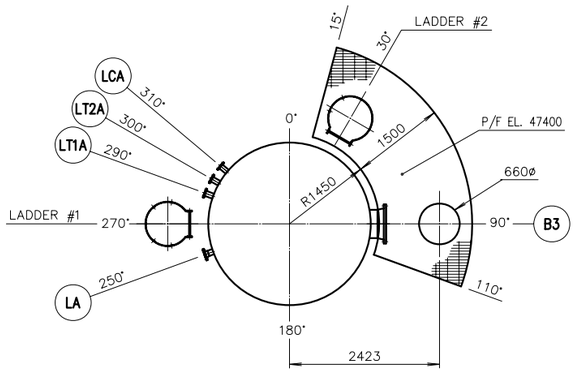


EL. 47400 ~ EL. 49300

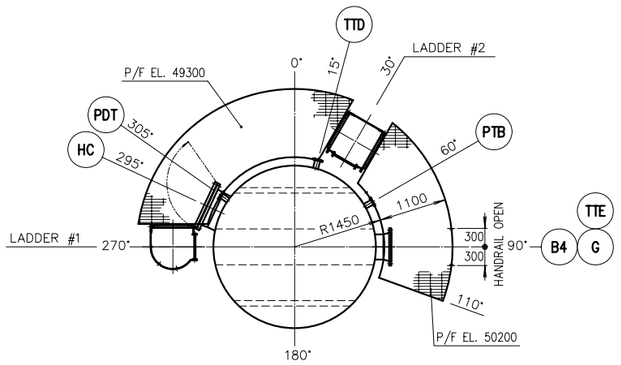


EL. 49300 ~ EL. 55300

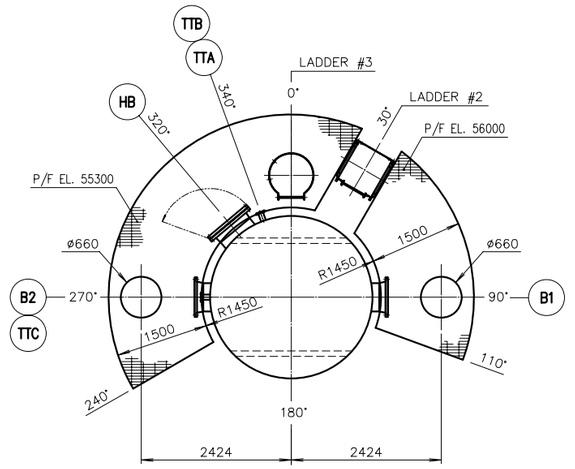


EL. 55300 ~ EL. 62700

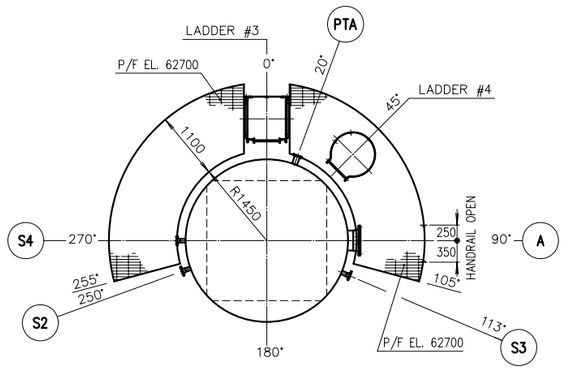

EL. 62700 ~ EL. 64750

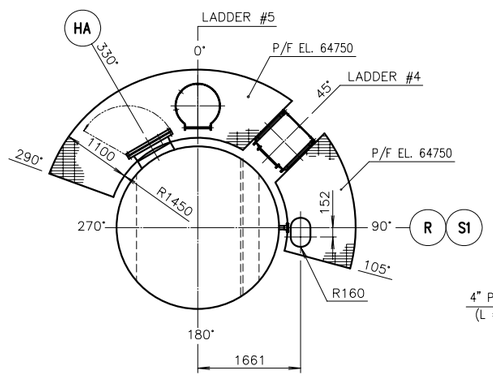

EL. 64750 ~ EL. 67200

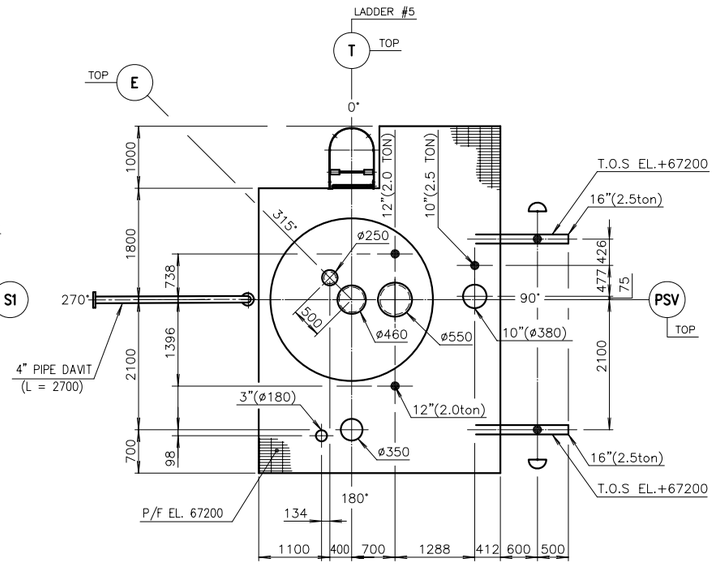

EL. 67200 ~ EL. ABOVE

NOTE

1. INDICATED LOADS SHOULD BE CONSIDERED BY VESSEL VENDOR AS EXTERNAL LOADS.

REV.	DATE	DESCRIPTION	ORIG.	PREP.	CHKD.	APPD.	CONT. APPD.
4	28/FEB/'09	AS BUILT	GS	N.H.L.	D.H.L.	S.R.K.	S.S.P.
3	16/FEB/'06	FOR FINAL	GS	N.H.L.	D.H.L.	S.R.K.	S.S.P.
2	05/AUG/'05	APPROVED FOR CONSTRUCTION	GS	N.H.L.	D.H.L.	S.R.K.	S.S.P.
1	30/JUL/'04	ISSUED TO COMPANY	LG	N.H.L.	D.H.L.	S.R.K.	S.S.P.
A	10/MAY/'04	ISSUED FOR REVIEW	LG	N.H.L.	D.H.L.	S.R.K.	S.S.P.

SOUTH PARS GAS FIELD DEVELOPMENT-
PHASES 9 & 10, ASSALUYEH-IRAN
ONSHORE FACILITIES

N I O C
PARS OIL AND GAS COMPANY

PROJECT No.: POGC-760-81-156 | DOC. CLASS. 2 | SCALE : NONE

OIEC | IOEC

TITLE:

103-C-101/201
CONDENSATE STABILISER

DWG No. DW-6340S-103-0510-0101 | SHEET No. 4 OF 4 | REV. 4

NOTE: THIS DOCUMENT IS A PROPERTY OF NIOC AND CAN NOT BE COPIED AND HANDED TO THIRD PARTY WITHOUT CLIENT'S AUTHORIZATION
CAD REFERENCE No.